

parcels)

**Parcel Number: (Include ALL** 

**Authorized Representative's** 

**Business Name:** 

## Planning/Zoning Application

WD-110-1, WD-758L-94

## **Submitted On:**

Jul 23, 2025, 11:19AM EDT

## Planning & Zoning Department

Nearest property address to the Street Address: 1305 Lourdes Avenue

project site:	City: De Pere
	State: W
	<b>Zip:</b> 54115
Check each project type that is being applied for:	Site Plan
Current De Pere Zoning Districts:	PI-1
Existing Site Land Uses:	Public & Civic
Proposed Site Land Uses:	Public & Civic
Does the project comply with the Comprehensive Plan?	Yes
Has City Staff been contacted for a preapplication meeting?	Yes
Property Owner:	First Name: St. Joseph Congregation  Last Name:
Is the property owner's address the same as the nearest	No
property address?	
Property Owner's Address:	Street Address: 1307 Lourdes Avenue
	City: De Pere
	State: W
	<b>Zip:</b> 54115
Property Owner's Phone Number:	920-336-4033
Property Owner's Email Address:	parish@lourdesdepere.org
Is someone processing the project for the property owner as their authorized representative?	Yes
Authorized Representative's Name:	First Name: Bill Last Name: Harrington

Tweet/Garot Mechanical, Inc.

Authorized Representative's Phone Number:		920-680-9250	
Authorized Representative's Email Address:		William.Harrington@tweetgarot.com	
Please attach a PDF copy of the site plan.		OLOL Site Plan - Chiller Enclosure 072325.pdf	
Would you like a basic checklist of information to include in the site plan?			
How do you plan on paying for your application?		Online with a credit card	
Total Due:		\$350.00	
Signature Data	Last Nam Email Add	First Name: Bill Last Name: Harrington Email Address: William.Harrington@tweetgarot.com  Signed at: July 23, 2025 10:59am America/New_York	
User's Session Information		IP Address: 69.11.197.122 Referrer URL:	
		THE STATE OF THE S	

## CITY OF DE PERE

335 South Broadway, De Pere, WI 54115 | www.de-pere.org



July 24, 2025

**Bill Harrington** Tweet/Garot Mechanical INC 325 Reid ST De Pere, WI 54115

RE: Site Plan Review for the Our Lady of Lourdes Chiller Enclosure at 1305 Lourdes AV (Parcel WD-110-1)

Dear Bill:

Thank you for the site plan for the Our Lady of Lourdes Chiller Enclosure at 1305 Lourdes AV. The City of De Pere staff reviewed the site plan on July 24, 2025, and recommended approval with no conditions.

You may now proceed to the Inspection Division to begin the process of obtaining permits. Should you have any questions regarding the decision or require further information, feel free to contact me at 339-4043 or pschleinz@deperewi.gov.

Should you have any questions regarding the decision or require further information, feel free to contact me at 339-4043 or pschleinz@deperewi.gov.

Sincerely,


Peter Schleinz

Senior Planner | Zoning Administrator

Futer Schley

cc: Daniel J. Lindstrom, AICP, Development Services Director

Dennis Jensen, Senior Building Inspector

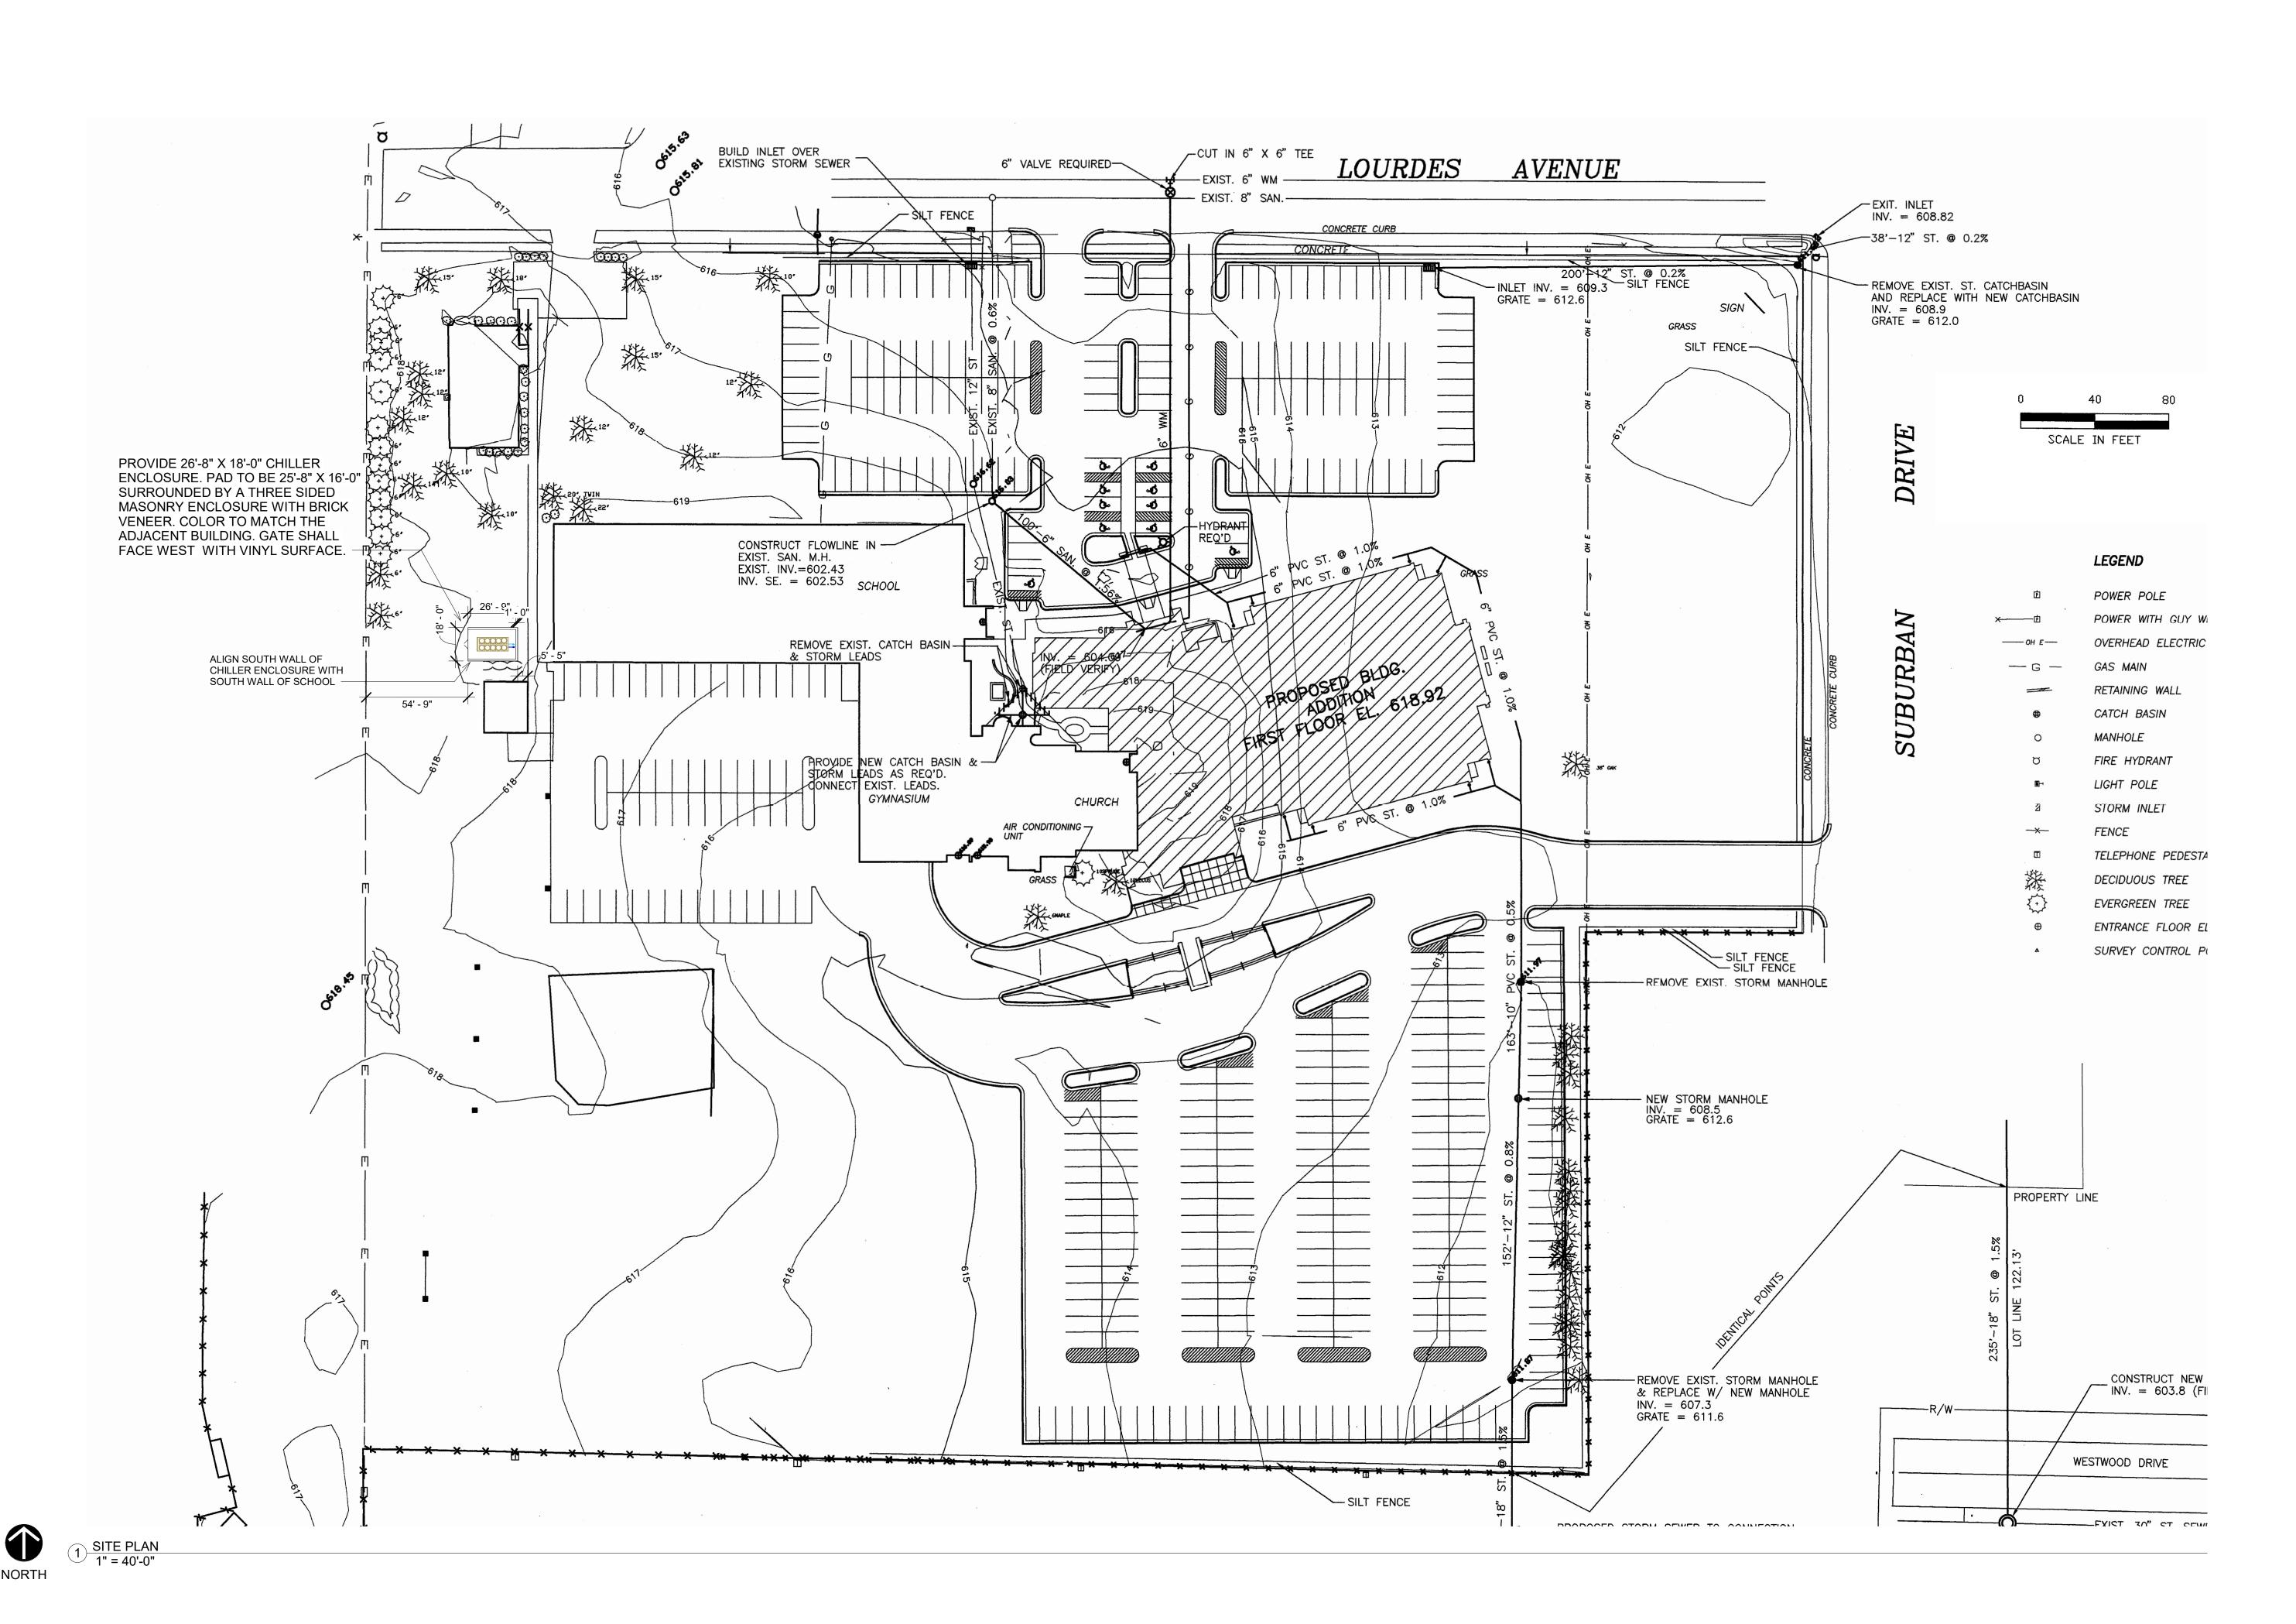

OUR LADY OF LOURDES

DE PERE SCHOOL COOLING UPGRADE

1305 LOURDES AVE, DE PERE, WI 54115

ISSUANCE HISTORY
P/Z REVIEW 7/23/25


SHEET REVISIONS

TITLE
SITE PLAN

JOB#: 43978
DRAWN BY: HJS
CHECKED BY: WPH
SCALE: AS SHOWN

C001

STINE SHOULD MEASURE 1" LONG

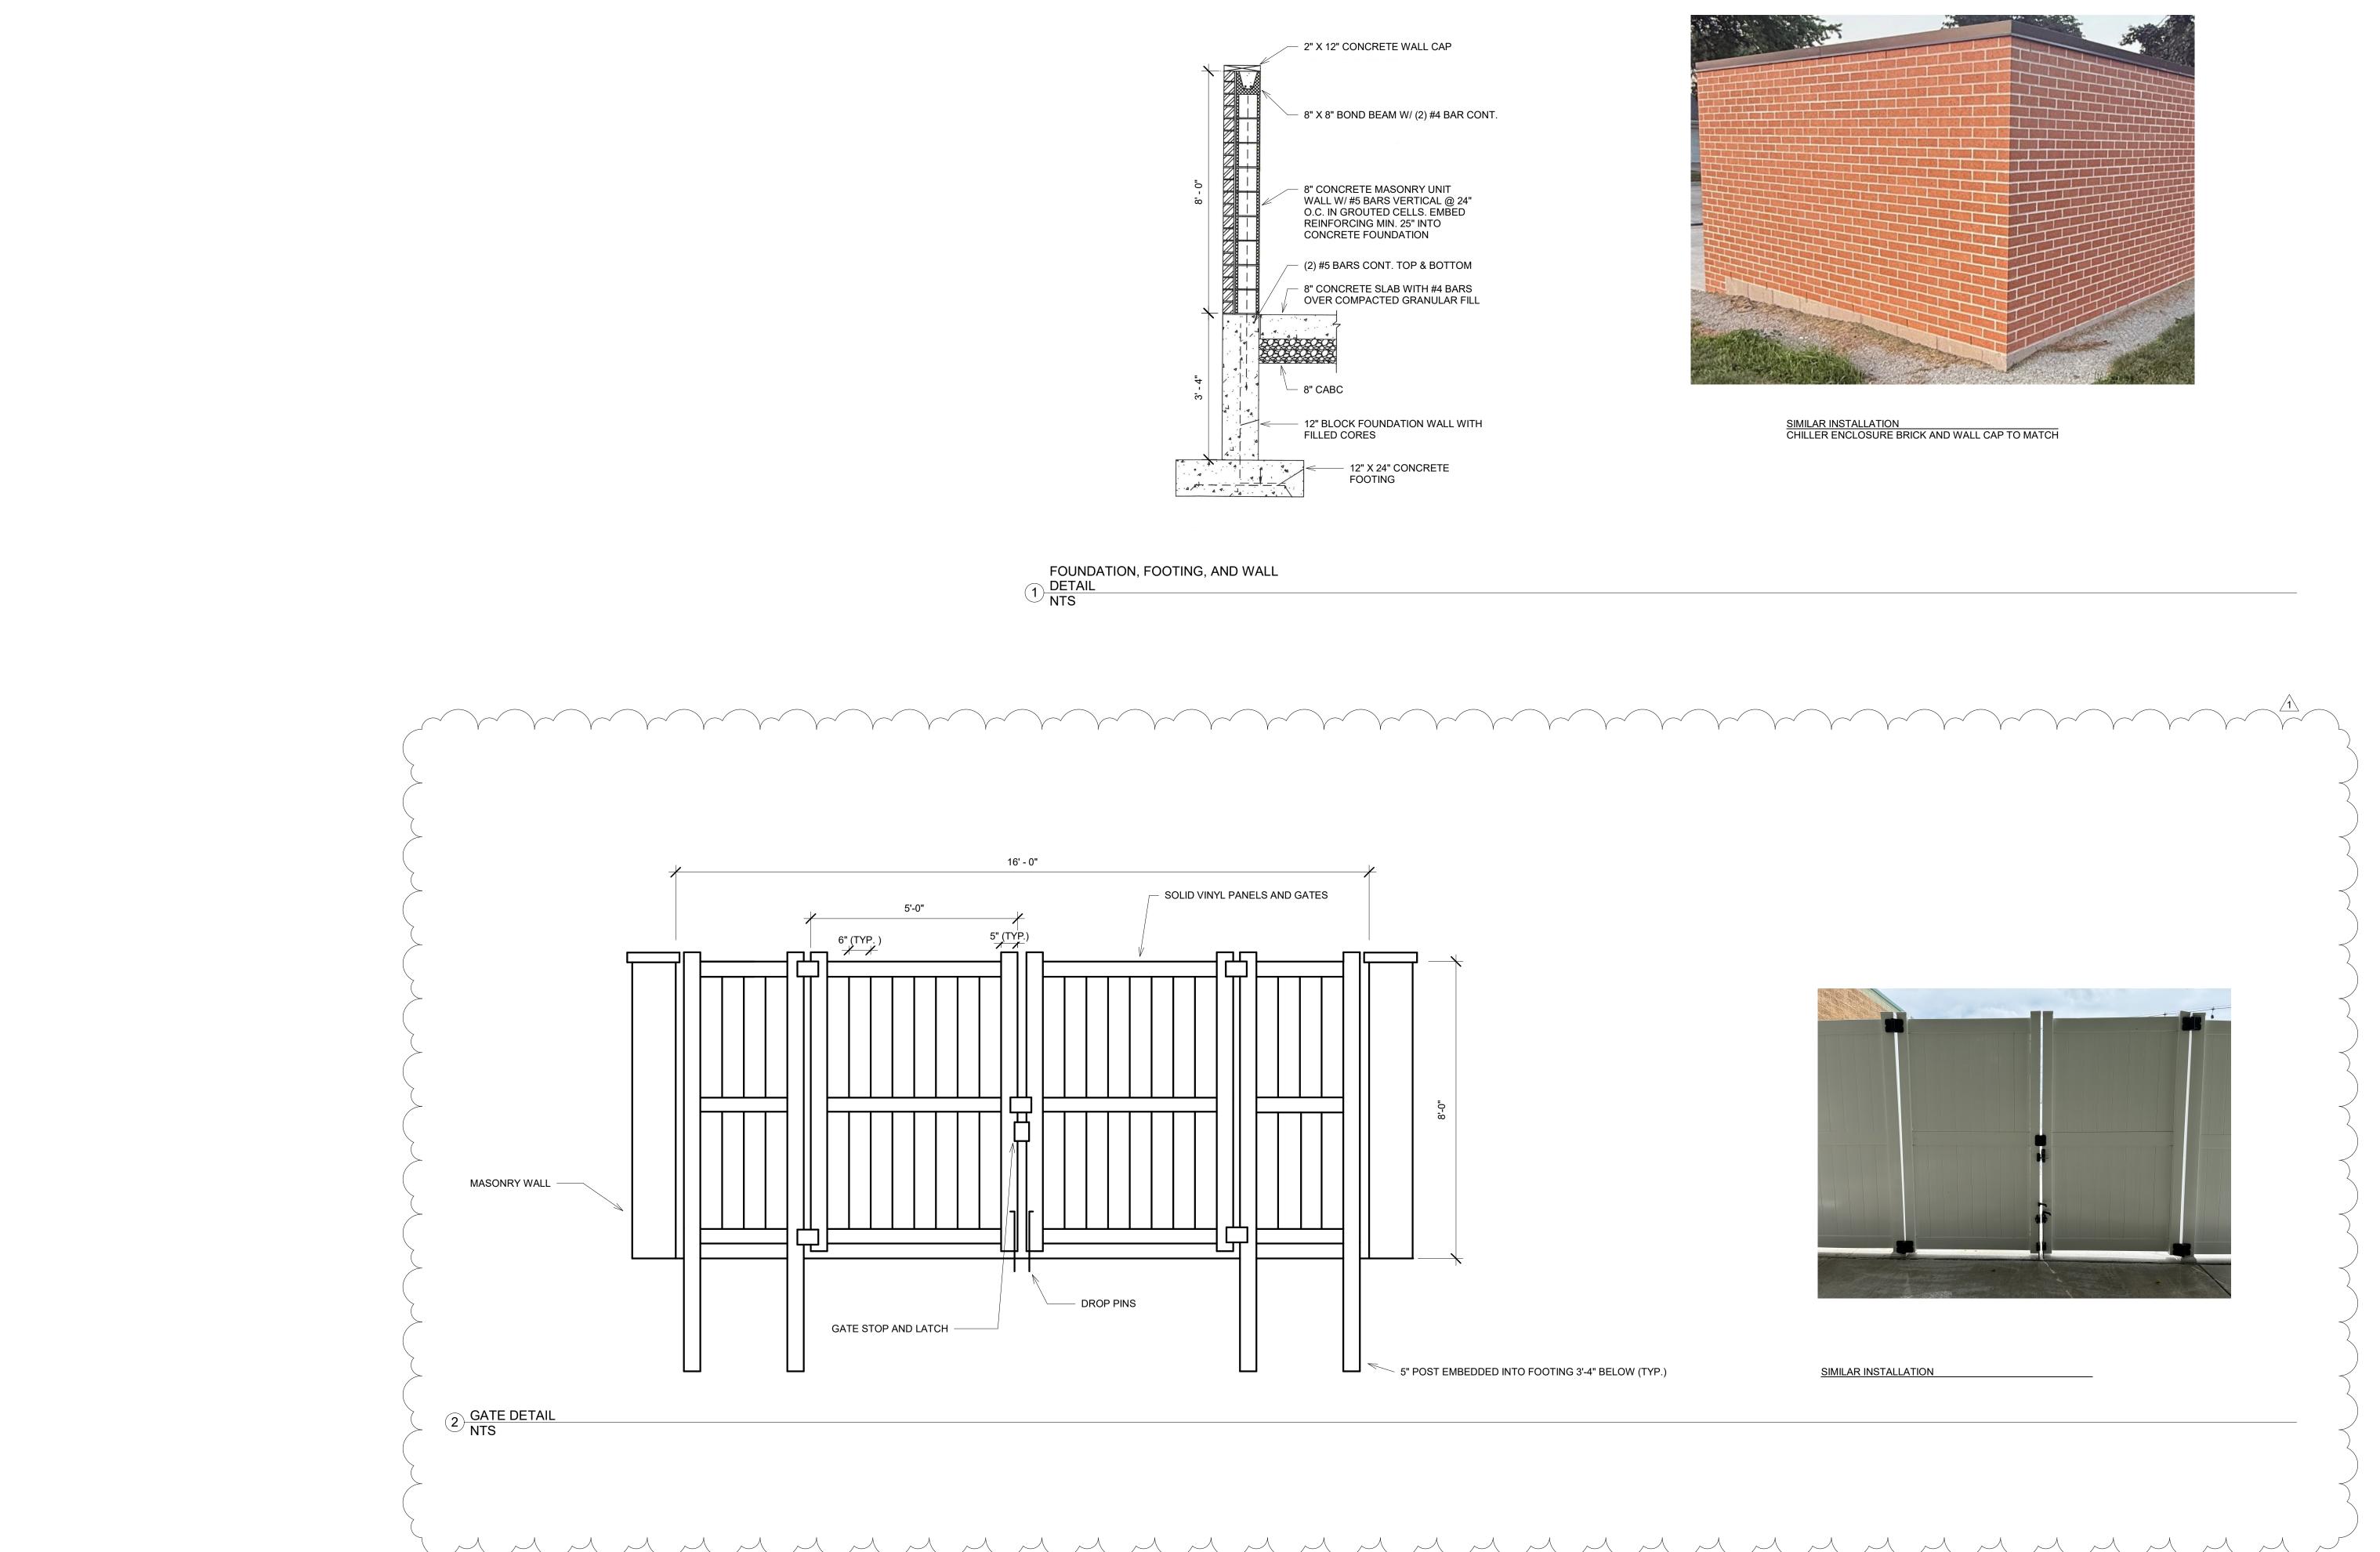



1305

ISSUANCE HISTORY P/Z REVIEW 7/23/25 SHEET REVISIONS 1 GATE DETAIL 7/24/25

SITE DETAILS

43978 DRAWN BY: HJS CHECKED BY: AS SHOWN

C002